
WEST VIRGINIA SEPTIC TANK INSPECTION FORM

GRANT C.O Health Department Installation Permit No. SS1295035
Name of Owner RICHARD C & MARBARET L WILSON
Address 18192 MARYLAND HIGHWAY, SWANTON, MD. 21561
Property Address NORTH FORK RETREAT SUBJULSION LOT 9 SECTION A
DESCRIPTION & NUMBER OF UNITS SERVED
Type Facility Served MOBILE Home No. Water Closets
Lot Size Acre sa.ft. Area suitable for sewage disposal installation 10,000 sq.ft.
Source of Water Supply Public No. Lavatories
No. Bedrooms 3 No. Showers or Tubs No. Baths
No. Garbage Grinders No. Automatic Washers
PRE-CAST Material Concrete Length x Width x Depth = cubic feet
Liquid Depth ft. Liquid Capacity 1000 gal.
Distance to: Dwelling 14' Water Supply Nearest Property Line 10+
SOIL ABSORPTION SYSTEM
Type Drain Line Material PLASTIC Trench Width 36 Inches
Trench Depth 36 Inches Total Absorption area in Trench Bottom sq. ft.
Diameter of Drain Line 4 Inches Type Filter Media Limestone CHIFS
No. of Drain Lines 3 Depth Filter Media Under Drain Line $6-8$ Inches
Length of Each Line 100,100,30, ft. Depth Filter Media Over Drain Line 2 in.
Distance of Disposal Field to: (a) Dwelling 29'
(b) Water Supply Na (c) Nearest Property Line Est. 40' (Side)
An inspection of the septic tank system described herein disclosed that said system (MEETS) DOES MEET) the minimum standards established by the West Virginia State Department of Health.
19 APRIL 95 Date Sanitarian Sanitarian

SKETCH OF SYSTEM TO BE DRAWN ON BACK

Note: Copy of this inspection report must be given to owner and the original filed in the Health Department files. PERMANENT RECORD - DO NOT DESTROY.

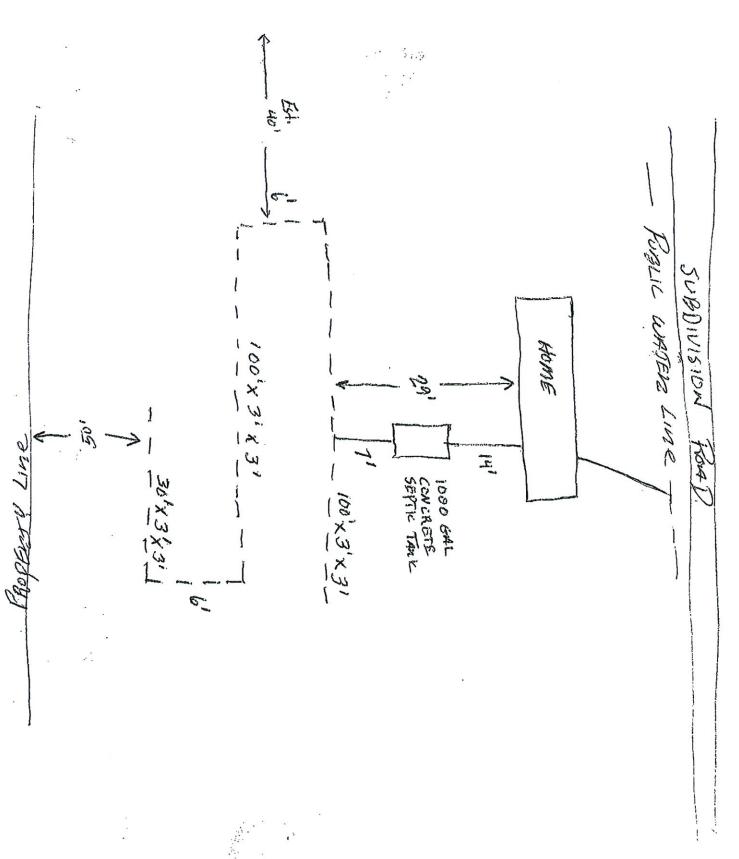

y. .