

WEST VIRGINIA
SEPTIC TANK INSPECTION FORM

Pend. Co. Health Department Installation Permit No. SS-36-93-035

Name of Owner WINTON E. JOSEPH

Address HC 69 BOX 19 BRANDYWINE WV 26802-9504

Property Address EAST OF BRANDYWINE

DESCRIPTION & NUMBER OF UNITS SERVED

Type Facility Served FOOD SER. No. Water Closets _____

Lot Size 2 A ~~sq~~ ft. Area suitable for sewage disposal installation _____ sq.ft.

Source of Water Supply PUBLIC No. Lavatories _____

No. Bedrooms _____ No. Showers or Tubs _____ No. Baths _____

No. Garbage Grinders _____ No. Automatic Washers _____

32 SEATING CAP.

SEPTIC TANK

Material PRECAST Length _____ x Width _____ x Depth _____ = _____ cubic feet

Liquid Depth _____ ft. Liquid Capacity 2-1000 gal.

Distance to: Dwelling 25' Water ~~Supply~~ ^{LIVE} 25+' Nearest Property Line 50+'

SOIL ABSORPTION SYSTEM

Type Drain Line Material PLASTIC Trench Width 36 Inches

Trench Depth 36-48 Inches Total Absorption area in Trench Bottom 1770 sq. ft.

Diameter of Drain Line 4 Inches Type Filter Media LIMESTONE

No. of Drain Lines 9 Depth Filter Media Under Drain Line 6 Inches

Length of Each Line 65 65 65 65 70 ft. Depth Filter Media Over Drain Line 2 in.

Distance of Disposal Field to: (a) Dwelling 38'

(b) Water ~~Supply~~ ^{LIVE} 40' (c) Nearest Property Line 50+'


An inspection of the septic tank system described herein disclosed that said system (~~MEETS~~, ~~DOES NOT MEET~~) the minimum standards established by the West Virginia State Department of Health.

JANUARY 7, 1993
Date

[Signature]
Sanitarian

SKETCH OF SYSTEM TO BE DRAWN ON BACK

Note: Copy of this inspection report must be given to owner and the original filed in the Health Department files. PERMANENT RECORD - DO NOT DESTROY.

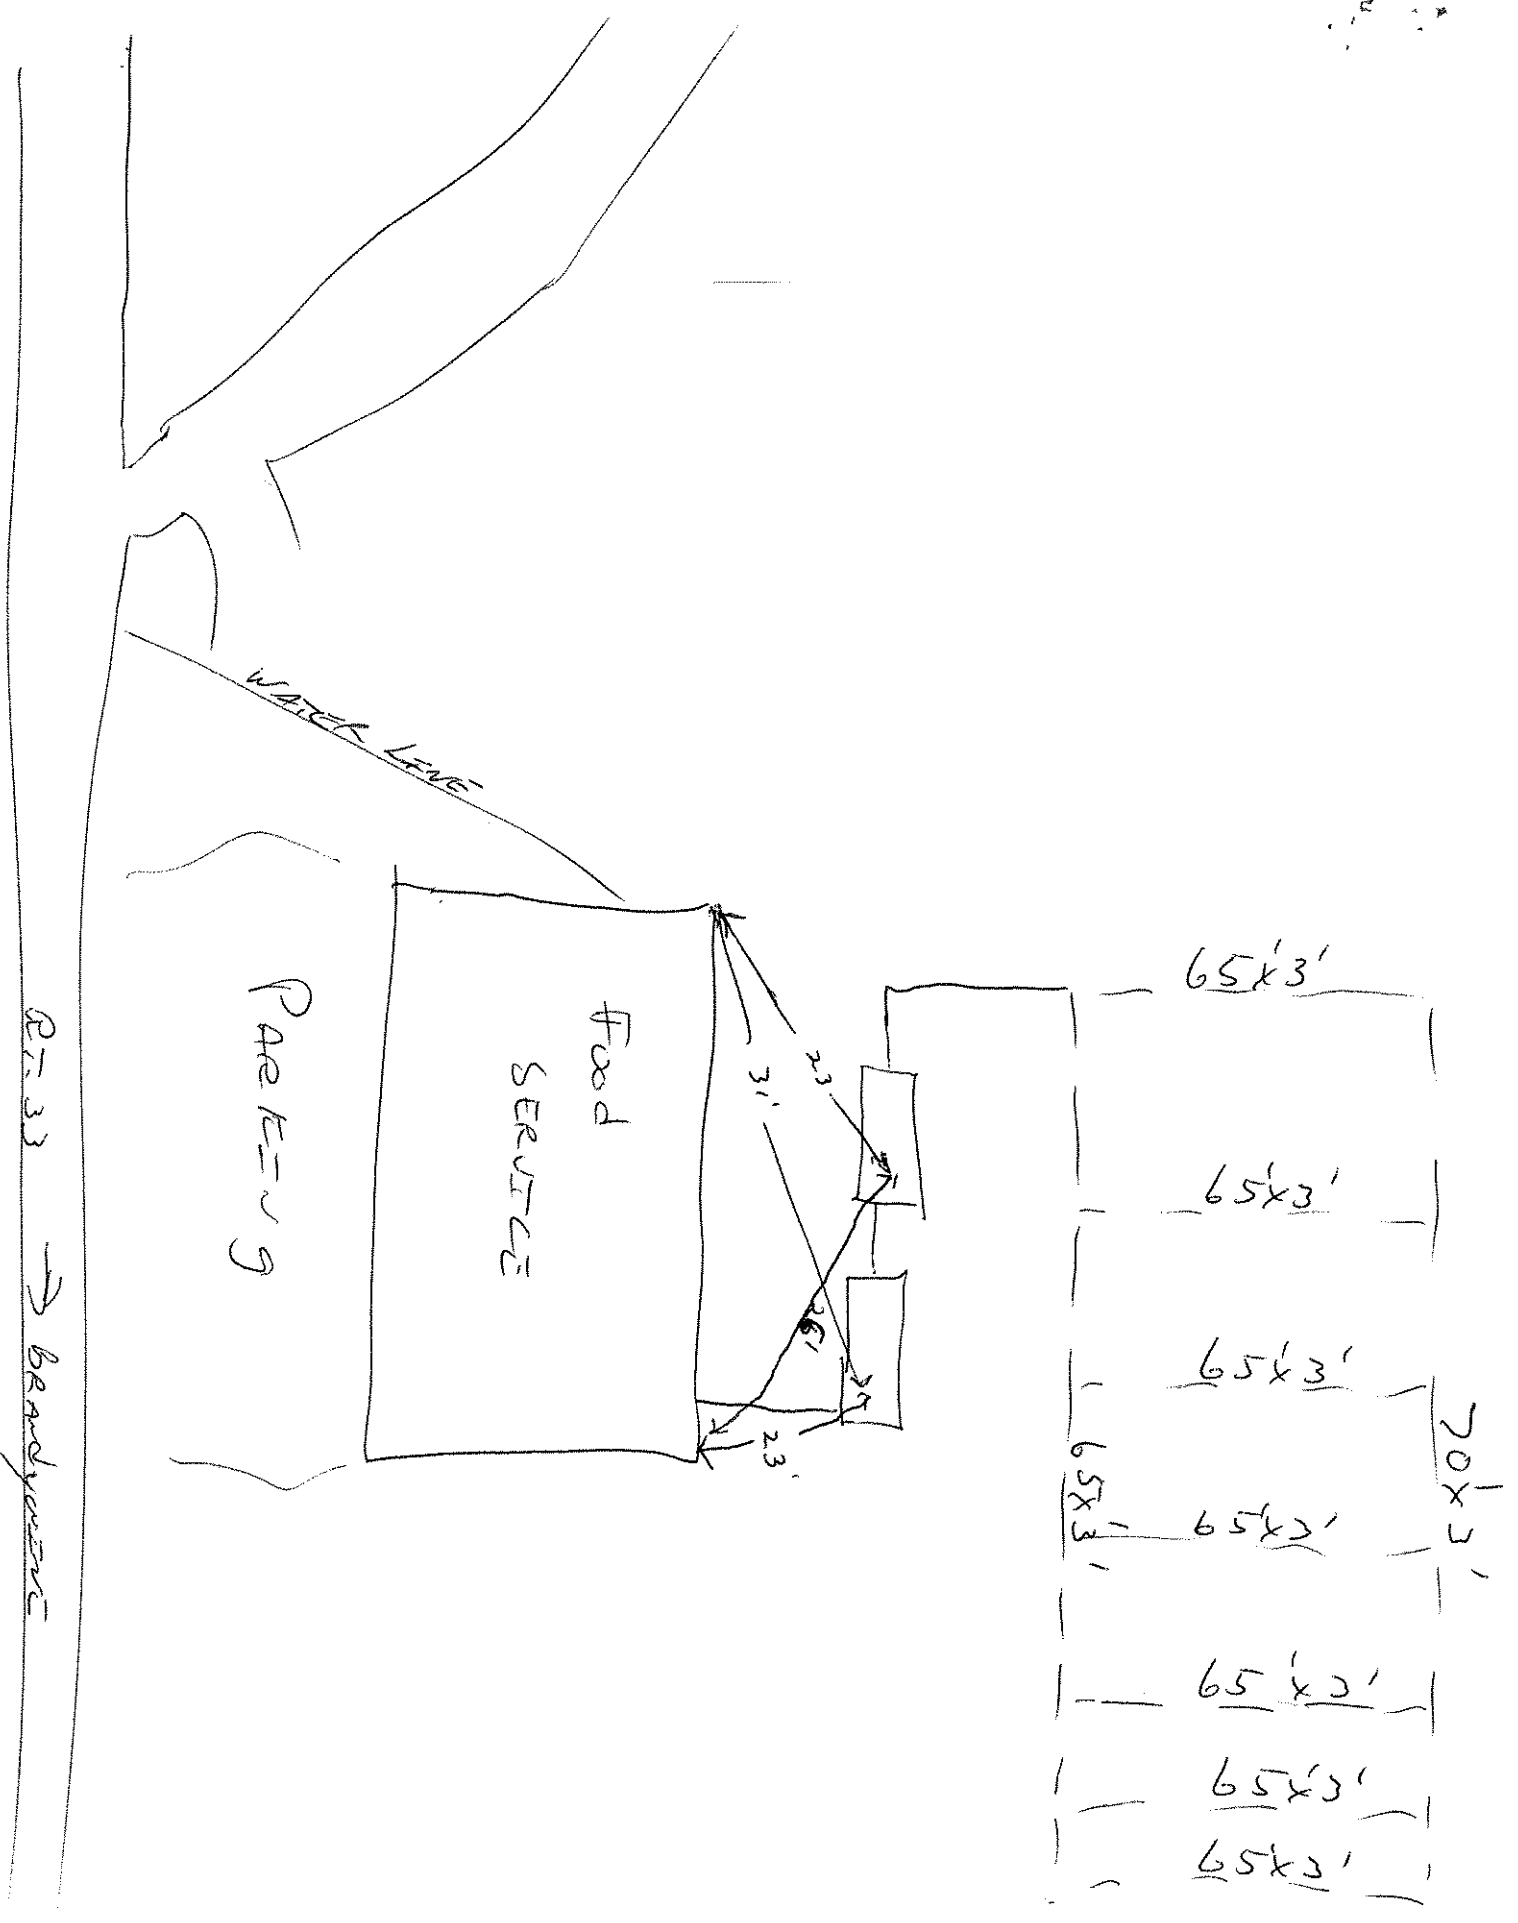

PARKING

Food SERVICE

WATER LEVEL

$65 \times 3'$

$65 \times 3'$

$70 \times 3'$

$23'$

$31'$

$23'$

$23'$

$23'$

$23'$

P.L. 33 → BRANDYMEANT